THIS DRAWING IS UNPUBLISHED. RELEASED FOR PUBLICATION ,19 .
© COPYRIGHT 19 BY AMP INCORPORATED. ALL RIGHTS RESERVED.


DO NOT SCALE


CAD AutoCAD DO NOT REVISE EXCEPT BY CAD


LOC AP DIST

REVISIONS


P	LTR	DESCRIPTION	DATE	DWN	APVD
	G	REDRAWN BY CAD ECLB0108/99	28APR99	HL	PLF
	H	REVISED BY ECLB0067/00	11DEC00	AP	PLF
	H1	**REVISED PER ECO-09-026444**	27NOV09	KK	AEG

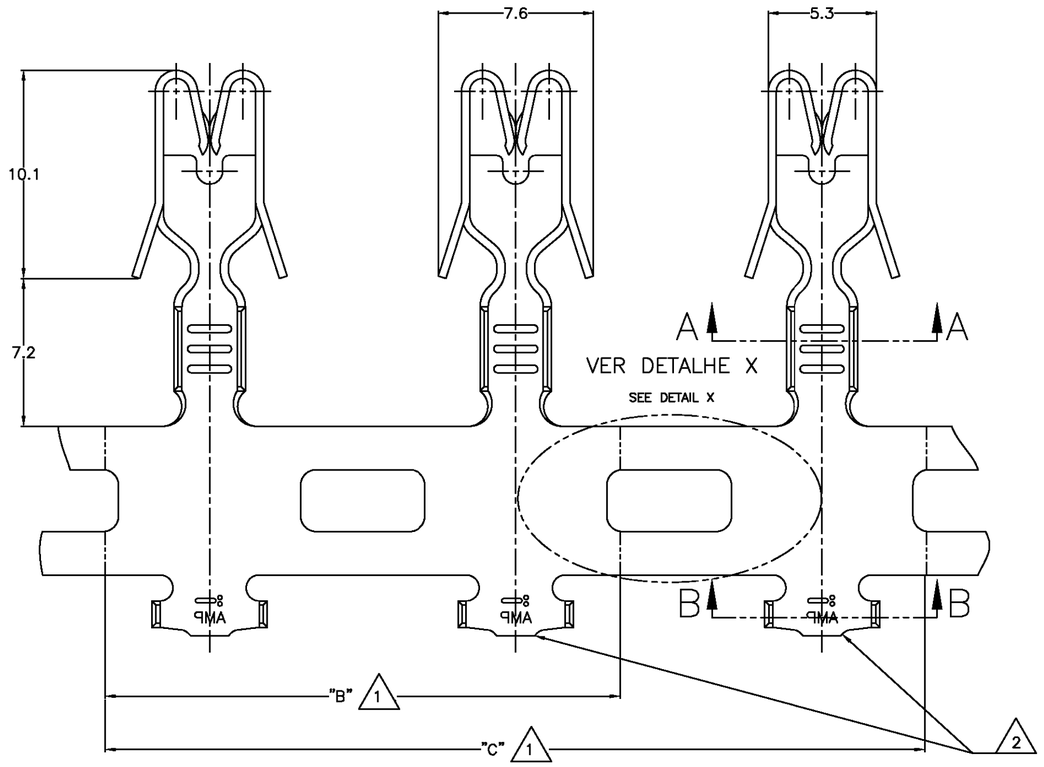

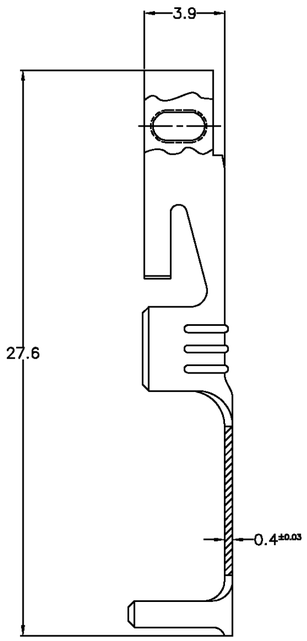


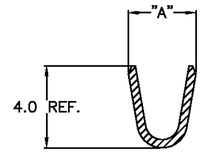

CORTE A–A
SECTION A–A

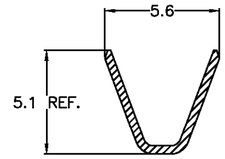

CORTE B–B
SECTION B–B

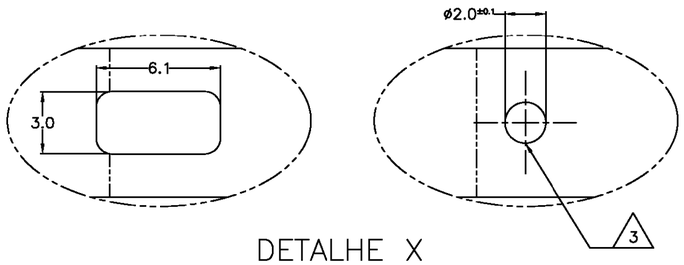

DETALHE X

DETAIL X

	"C"	"B"	"A"	NÚMERO DE CONTATOS NUMBER OF CONTACTS	ACABAMENTO FINISH	MATERIAL	PART REV.	PART NUMBER
	DIMENSÃO/DIMENSION							
OBSOLETED ➡	~~40,2~~	~~–/–~~	~~3,9~~	~~3~~	~~ESTANHADO/TIN PLATTED~~	~~LATÃO/BRASS~~	~~H~~	~~1–626499–4~~ 3
OBSOLETED ➡	~~40,2~~	~~–/–~~	~~3,9~~	~~3~~	~~–––––/–––––~~	~~LATÃO/BRASS~~	~~H~~	~~1–626499–3~~ 3
OBSOLETE 4	40,2	–/–	3,6	3	ESTANHADO/TIN PLATTED	LATÃO/BRASS	H	~~1–626499–2~~
	40,2	–/–	3,6	3	–––––/–––––	LATÃO/BRASS	H	~~1–626499–1~~
OBSOLETED ➡	~~–/–~~	~~25,2~~	~~3,9~~	~~2~~	~~ESTANHADO/TIN PLATTED~~	~~LATÃO/BRASS~~	~~H~~	~~626499–4~~ 3
	–/–	25,2	3,9	2	–––––/–––––	LATÃO/BRASS	H	626499–3 3
	–/–	25,2	3,6	2	ESTANHADO/TIN PLATTED	LATÃO/BRASS	H	626499–2
	–/–	25,2	3,6	2	–––––/–––––	LATÃO/BRASS	H	626499–1

1 – DIMENSÃO DE CORTE PARA APLICADOR
APPLICATOR CUT DIMENSION

2 – USO OPCIONAL, DE ACORDO COM A NECESSIDADE DO CLIENTE
OPTIONAL USE, ACCORDING TO THE CUSTOMER'S NEED

3 – PARA AMP ITÁLIA SOMENTE
FOR AMP ITALY ONLY

4 OBSOLETE PARTS: OBSOLETE CIS STREAMLINING PER D.RENAUD/D.SINISI

THIS DRAWING IS A CONTROLLED DOCUMENT.

DWN H.LIVERARO 22APR99
CHK P.L.FARIA 28APR99
APVD F.ALEXANDRONI 28APR99

AMP AMP do BRASIL Ltda.
São Paulo – Brasil

DIMENSIONS: MM

TOLERANCES UNLESS OTHERWISE SPECIFIED:
0 PLC ± –
1 PLC ± 0,25
2 PLC ± –
3 PLC ± –
4 PLC ± –
ANGLES ± –

INSUL. RANGE ø 3,0 – 4,3mm
WIRE RANGE 1,0 – 2,5 mm²
MATERIAL SEE TABLE
FINISH SEE TABLE

PRODUCT SPEC –
APPLICATION SPEC –
WEIGHT –

NAME FUSE CONTACT

SIZE	CAGE CODE	DRAWING NO	RESTRICTED TO
A2	00779	C-626499	–

CUSTOMER DRAWING | SCALE 5:1 | SHEET 1 OF 1 | REV H1

626499

AMP 1471-9 REV 23FEB95

22APR99 1:30pm lb020386