

THIS DRAWING IS UNPUBLISHED. RELEASED FOR PUBLICATION 20
© COPYRIGHT 20 BY - ALL RIGHTS RESERVED.


LOC	DIST
AP	-


REVISIONS


P	LTR	DESCRIPTION	DATE	DWN	APVD
	F	REDRAW BY ECO-06-026171	31JAN07	H.C	WLS
	F1	REVISED BY ECO 16-005803	28JUN2016	HC	WLS
	G	REVISED BY ECO 16-011418	16NOV2016	HC	WLS
	G1	REV. BY ECO 17-013917	20SEP2017	HC	HC

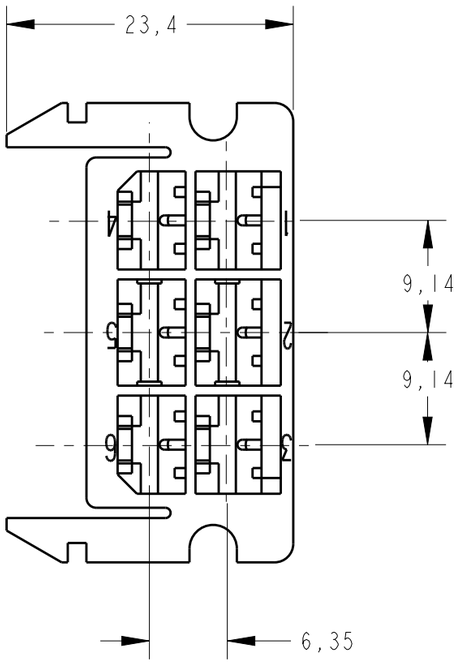


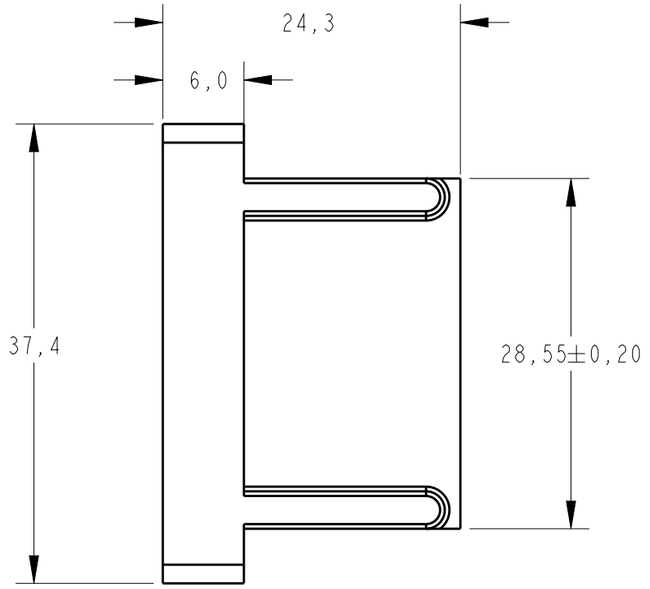

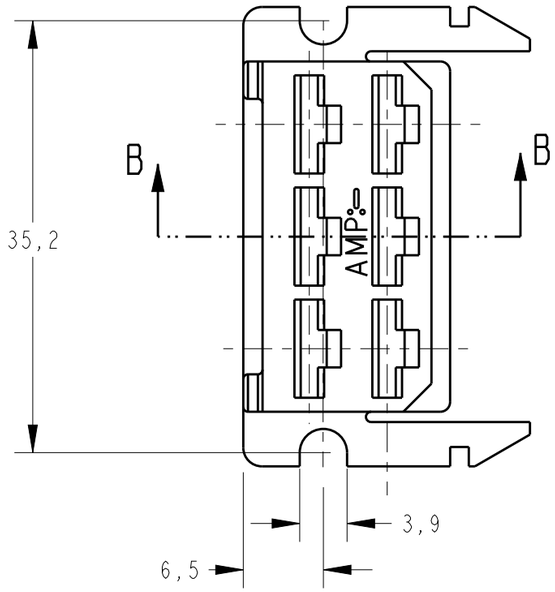

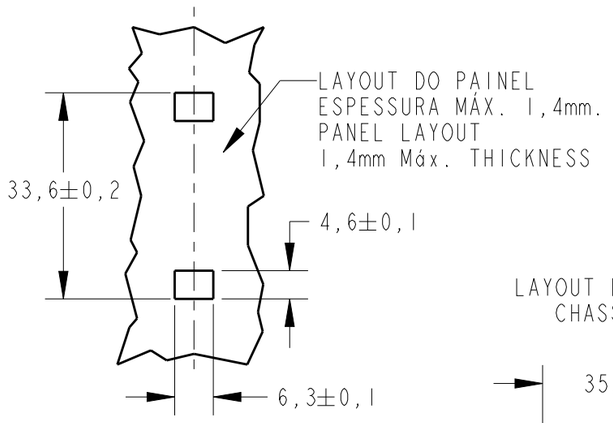

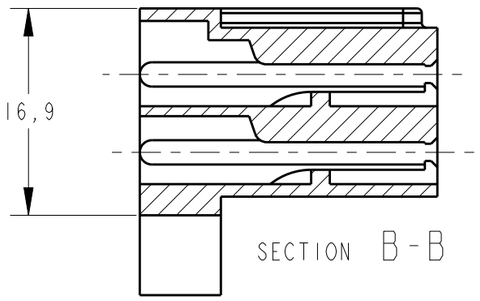

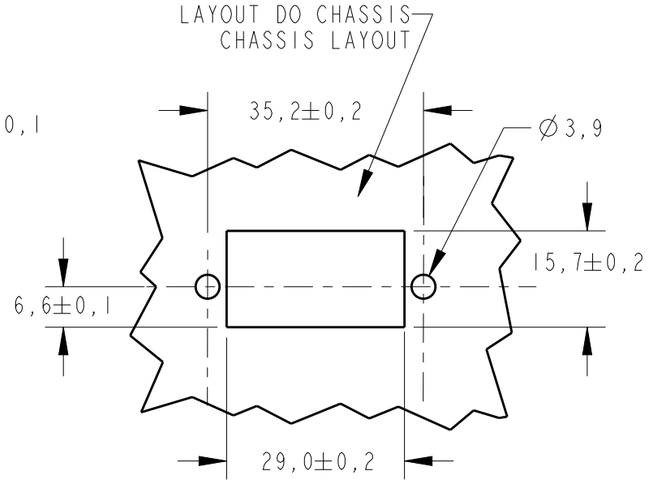

⚠1 -MATÉRIA-PRIMA CONFORME IEC 60335-1 GWT 750°C SEM CHAMA.
RAW MATERIAL ACC. TO IEC 60335-1 GWT 750°C WITHOUT FLAME.

OBSOLETE	~~NATURAL~~	~~PA 6.6~~ ⚠1	~~1-163006-0~~
OBSOLETE	~~LARANJA/ORANGE~~	~~PA 6.6~~	~~163006-9~~
OBSOLETE	~~VIOLETA/VIOLET~~	~~PA 6.6~~	~~163006-8~~
OBSOLETE	~~CINZA/GREY~~	~~PA 6.6~~	~~163006-7~~
OBSOLETE	~~MARROM/BROWN~~	~~PA 6.6~~	~~163006 6~~
OBSOLETE	~~PRETO/BLACK~~	~~PA 6.6~~	~~163006 5~~
OBSOLETE	~~AMARELO/YELLOW~~	~~PA 6.6~~	~~163006 4~~
OBSOLETE	~~AZUL/BLUE~~	~~PA 6.6~~	~~163006 3~~
OBSOLETE	~~VERDE/GREEN~~	~~PA 6.6~~	~~163006-2~~
	VERMELHO/RED	PA 6.6	163006-1
	NATURAL	PA 6.6	163006-0
	FINISH	MATERIAL	PART NUMBER

THIS DRAWING IS A CONTROLLED DOCUMENT.

DIMENSIONS: mm

TOLERANCES UNLESS OTHERWISE SPECIFIED:
0 PLC ±-
1 PLC ±0,3
2 PLC ±0,3
3 PLC ±-
4 PLC ±-
ANGLES ±-

MATERIAL -
FINISH -

DWN H.C.CANTERI 16OCT2006
CHK W.L.STEFANI 16OCT2006
APVD -
PRODUCT SPEC -
APPLICATION SPEC -
WEIGHT -

TE Connectivity

NAME
6 WAY FASTIN-ON
REC. HSG.
-

SIZE	CAGE CODE	DRAWING NO	RESTRICTED TO
A3	00779	C-163006	-

CUSTOMER DRAWING | SCALE 1/1 | SHEET 1 OF 1 | REV G1