

DO NOT SCALE
DIMENSIONS IN

METRIC


3rd ANGLE PROJECTION

C 881624

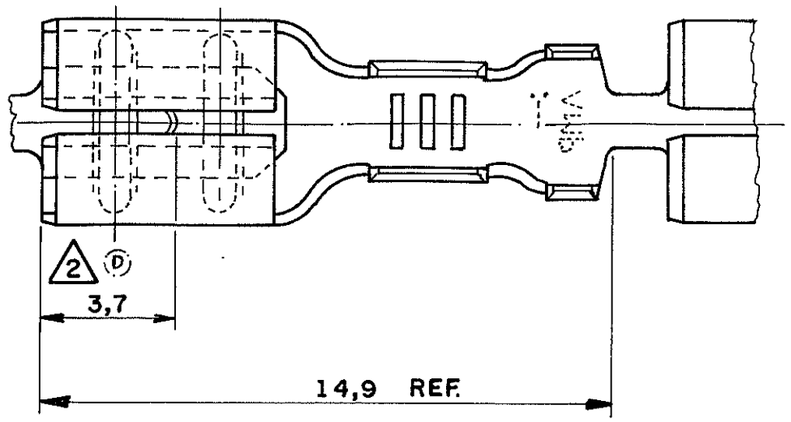


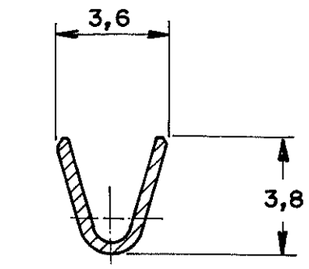

SECÇÃO **A - A**

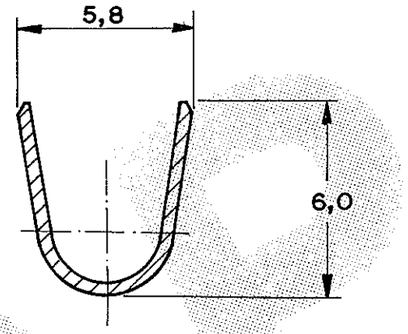

SECÇÃO **B - B**

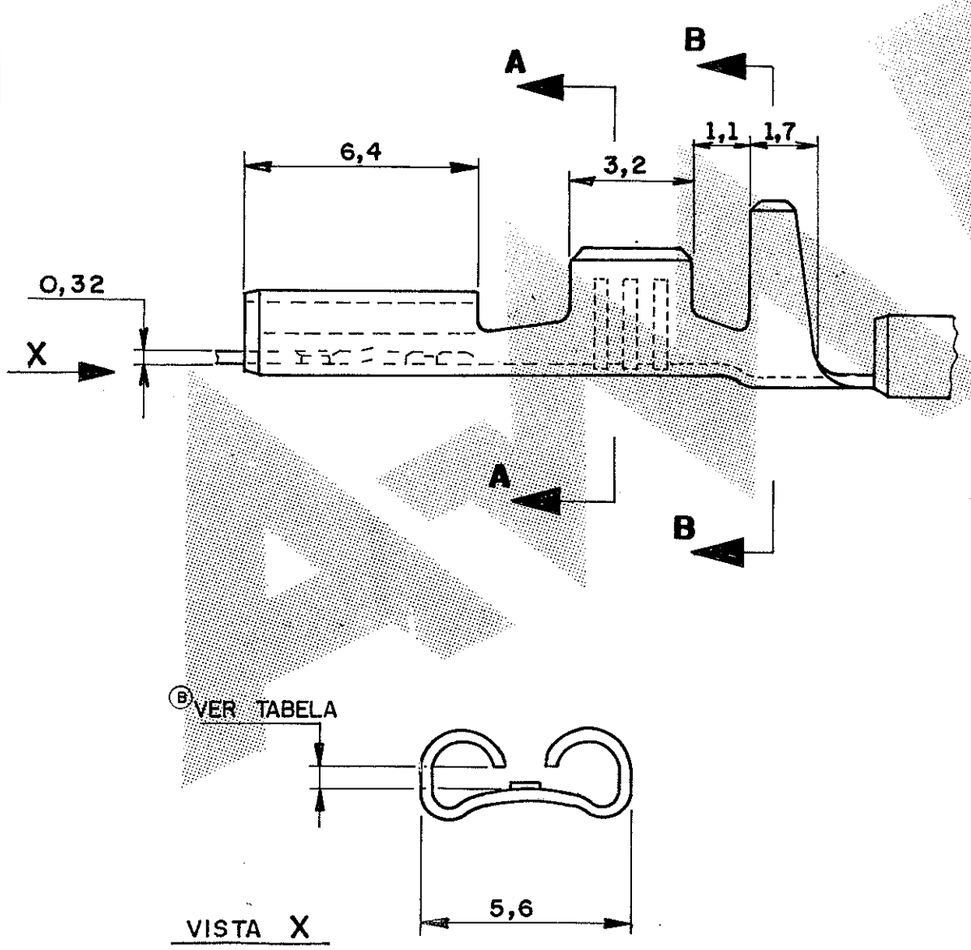

1 - PEÇA SOLTA - VER DESENHO 444 202 (C)
- LOOSE PIECE - SEE DWG. 444202.

(D) 2 LOCALIZAÇÃO DO DIMPLE - 3,0 mm. PARA O PN- 881624-8.
DIMPLE LOCATION - 3,0 mm. FOR PN-881624-8

3 OBSOLETE PARTS: OBSOLETE CIS STREAMLINING PER D.RENAUD/D.SINISI

3 OBSOLETE

(B) PARA LINGUETA	FINISH	MATERIAL	PART NUMBER
0,8 mm	——	LATÃO	2 (D) -8
	ESTANHADO	LATÃO	1 (C) -7
0,5 mm	——	LATÃO	1 (C) -6
OBSOLETO (C)	~~ESTANHADO~~	~~LATÃO~~	~~-5~~
OBSOLETO (C)	~~——~~	~~LATÃO~~	~~-4~~
	ESTANHADO	BRONZE FOSF.	~~-3~~
	ESTANHADO	LATÃO	1 (C) -2
0,8 mm	——	LATÃO	1 (C) 881624 -1

(C1)

CUSTOMER DWG for REFERENCE ONLY

ISS	REVISION RECORD	DR	CHK	DATE
E1	REVISED PER ECO-09-026444	KK	AEG	30NOV09
E	REACTIVED -1 BY LE 10-360-04	H.C.	H.C.	05 Nov 04
D1	REVISED BY EC 0413/01	H.C.	WLS.	16 OCT 01
D	REVISED BY EC -	H.C.	MFG	11 Feb 98
C1	REVISED BY EC-344/96	[illegible]	[illegible]	30 JUL 96
C	REVISED BY	H.C.	0283/94	22 JUL 94
B	ADICIONADO TRAÇO 6 E 7	PF	ECN 3607	11-01-93
A	ADICIONADO TRAÇO 4 E 5	Briz	ECN 3490	22-10-92
O	ERA P90-29507	DORI		01-04-91

THIS DRAWING IS UNPUBLISHED RELEASED FOR PUBLICATION 19
© COPYRIGHT 19 BY AMP DO BRASIL LTDA S.P. ALL INTERNATIONAL RIGHTS RESERVED AMP PRODUCTS MAY BE COVERED BY U.S. AND FOREIGN PATENTS AND/OR PATENTS PENDING.

TOLERANCES UNLESS OTHERWISE STATED
DEC. ± 0,3
ANGLES ± 1°

DR. 01-04-91 DOURIVAL ALVES ROCHA
CHK.
DE.
APP.

INS. DIA. RANGE	WIRE RANGE 2	SCALE
2,7 — 4,0mm	>1,0 — 2,5mm	—— // ——

AMP do BRASIL LTDA.
São Paulo, Brasil

DESCRIPTION
.187 SERIES FASTON REC.

A3 | DWG NO C 881624 | SHEET 1 OF 1