
DRAWING MADE IN AMERICAN PROJECTION

LTR	REVISION RECORD	DATE	DWN	APVD
A1	ECO-09-025273	13NOV09	KK	AEG

NUMBER C-160415

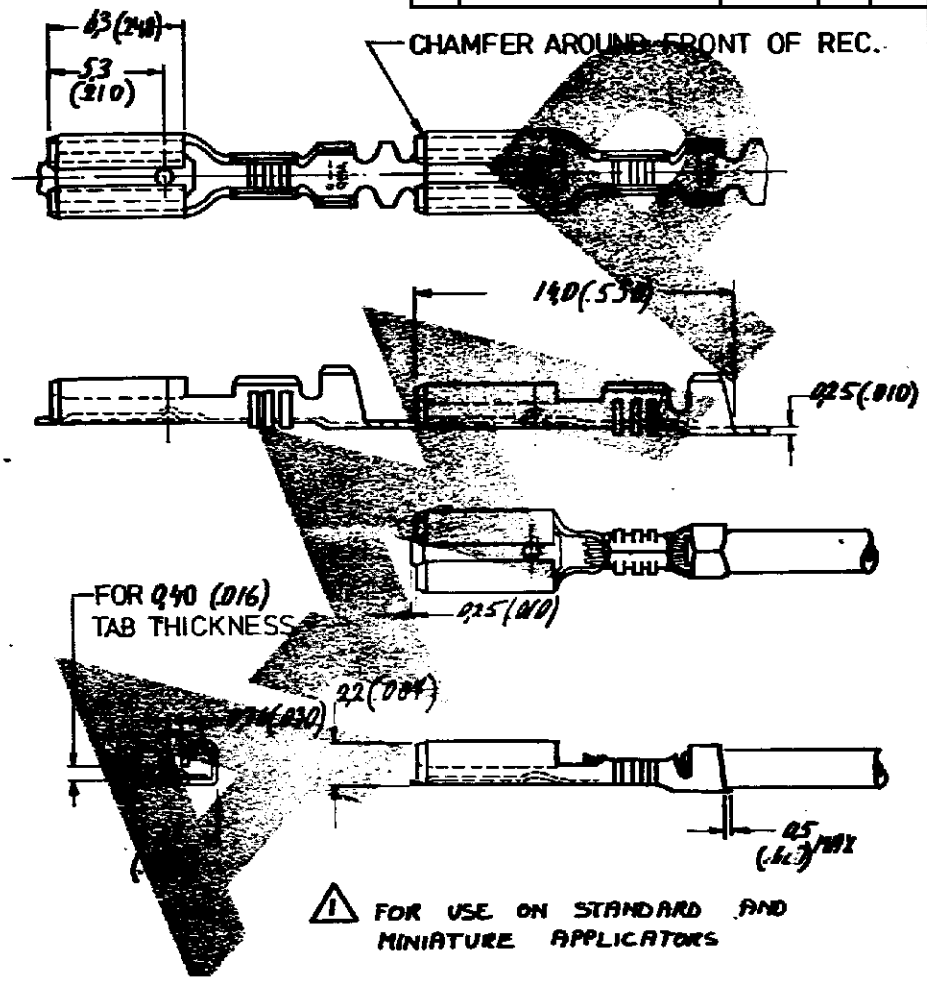

1 FOR USE ON STANDARD AND MINIATURE APPLICATORS

2 OBSOLETE PARTS: OBSOLETE CIS STREAMLINING PER D.RENAUD/D.SINISI

DIMENSIONS IN MM (INCHES) NOT SCALE PRINT

ORDER NO.	MATERIAL	PLATING
160415-5	STEEL	NICKEL 1
~~160415-3~~	2 BRASS	SILVER 1
160415-2		TIN 1
~~160415-1~~		1

DR V. Sustersen 5/11/79 DATE | DE DATE
CHK [illegible] 11.6.79 DATE | APP [illegible] 4.7.79 DATE

CUSTOMER COPY FOR REFERENCE ONLY

©1979 BY AMP-HOLLAND N.V. ALL RIGHTS RESERVED A-MP PRODUCTS COVERED BY PATENTS AND/OR PATENTS PENDING.

AMP

AMP-HOLLAND N.V.
's-Hertogenbosch

WIRE-RANGE 0.5 - 1.0 mm² | INSUL-RANGE (.080 - .120) 2.0 - 3.0

SCALE N.T.S. | SIZE A | NO C-160415 | REV A1

NAME .110 SERIES MINIATURE FASTON RECEPTACLE